















53100 KUALA LUMPUR

L : 603-2056540
X : 603-2056485

JANGOR DARUL EHSAN.

NOTE

- | | |
|---|--|
|  | <p>QWERTY - STANDARD ALPHABET</p> <p>QWERTZ - GERMAN ALPHABET</p> <p>QWERTZ - SWISS ALPHABET</p> <p>RECYCLED SYSTEM ALPHABET</p> |
|  | <p>QWERTZ - GERMAN ALPHABET</p> <p>QWERTZ - SWISS ALPHABET</p> <p>RECYCLED SYSTEM ALPHABET</p> |
|  | <p>QWERTZ - GERMAN ALPHABET</p> <p>QWERTZ - SWISS ALPHABET</p> |
|  | <p>QWERTZ - GERMAN ALPHABET</p> <p>QWERTZ - SWISS ALPHABET</p> |
DESPERITION	DATE	REV.



**JABATAN KERJA RAYA
MALAYSIA**

JARACONSULT SDN BHD
& E ENGINEERS

NO. 324-1 JALAN MIDAH BESAR
TAMAN MIDAH CHERAS,
56000 KUALA LUMPUR
TEL : 603-91738311
FAX : 603-91738377



KEJURUTERAN ASTRA
SDN.BHD.
35, JALAN UT/55, SECTION UT
HICOM GLENDAVE INDUSTRIAL PARK
40150 SHAH ALAM,
TEL. : 03-55696868
FAX : 03-55698980

ALUK LUKISA

EXTENSION OF THE KULLITYAH
OF ENGINEERING (BLOCK E5)
SECOND FLOOR PLAN

LE :	1500	
E :	JUN 2006	
NAME BY :	HARVE ADAM	
CKED BY :	JOHARUL	
MOVED BY :		
REFERENCE :		

AS BUILT DRAWING

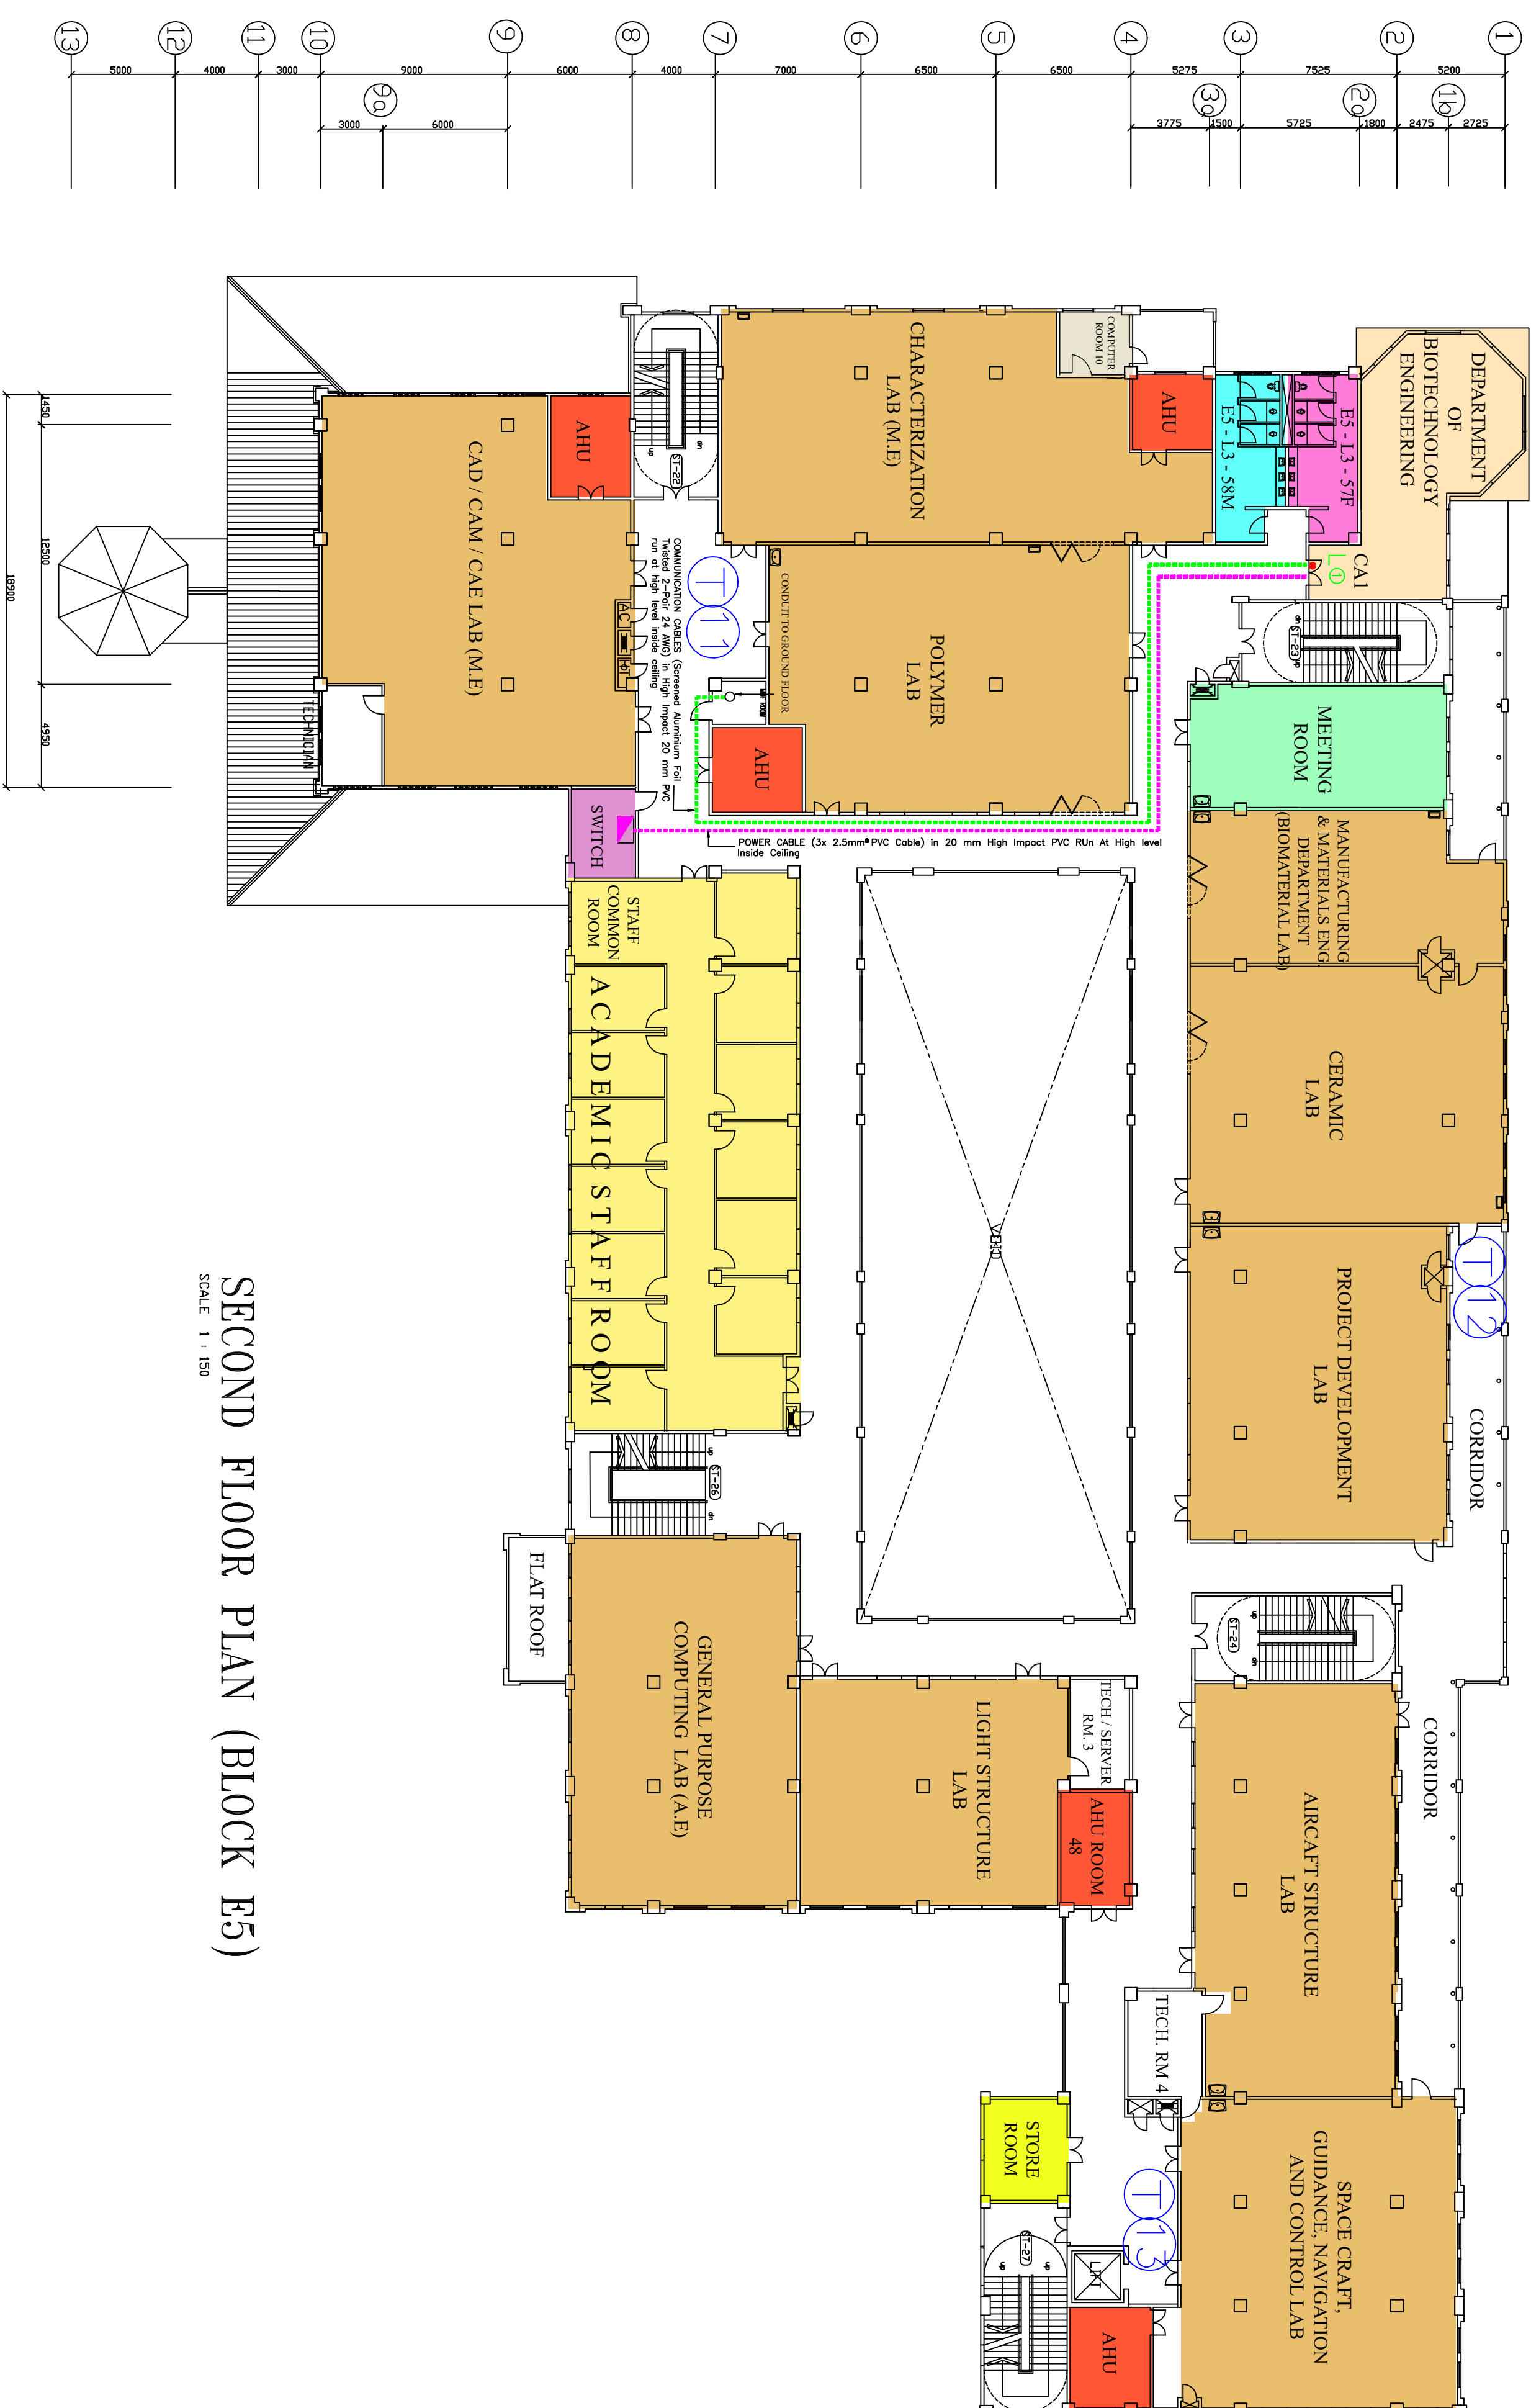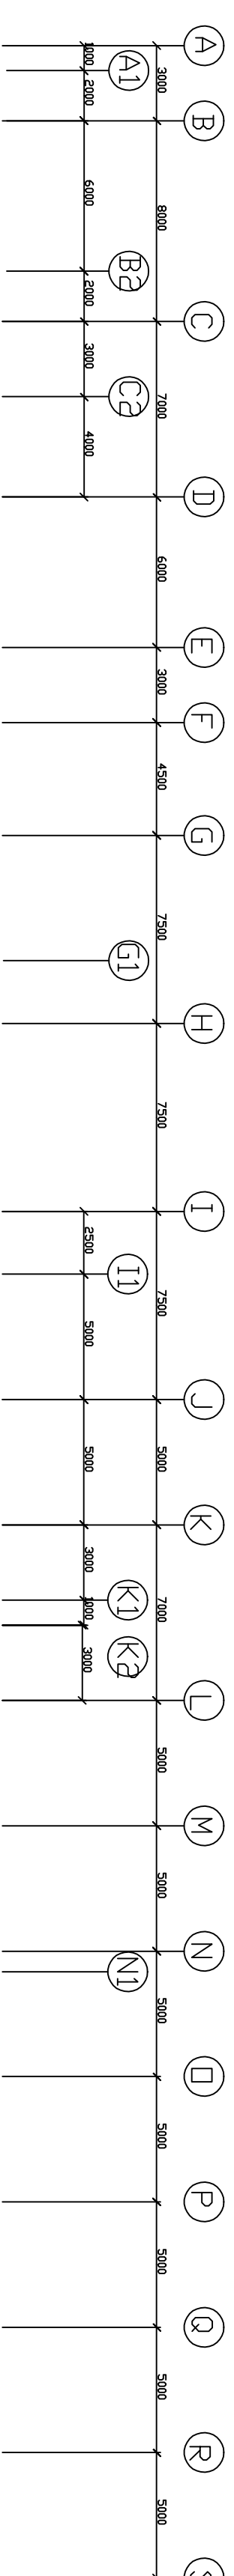

SECOND FLOOR PLAN (BLOCK E5)
SCALE 1 : 150

SCALE 1 : 15