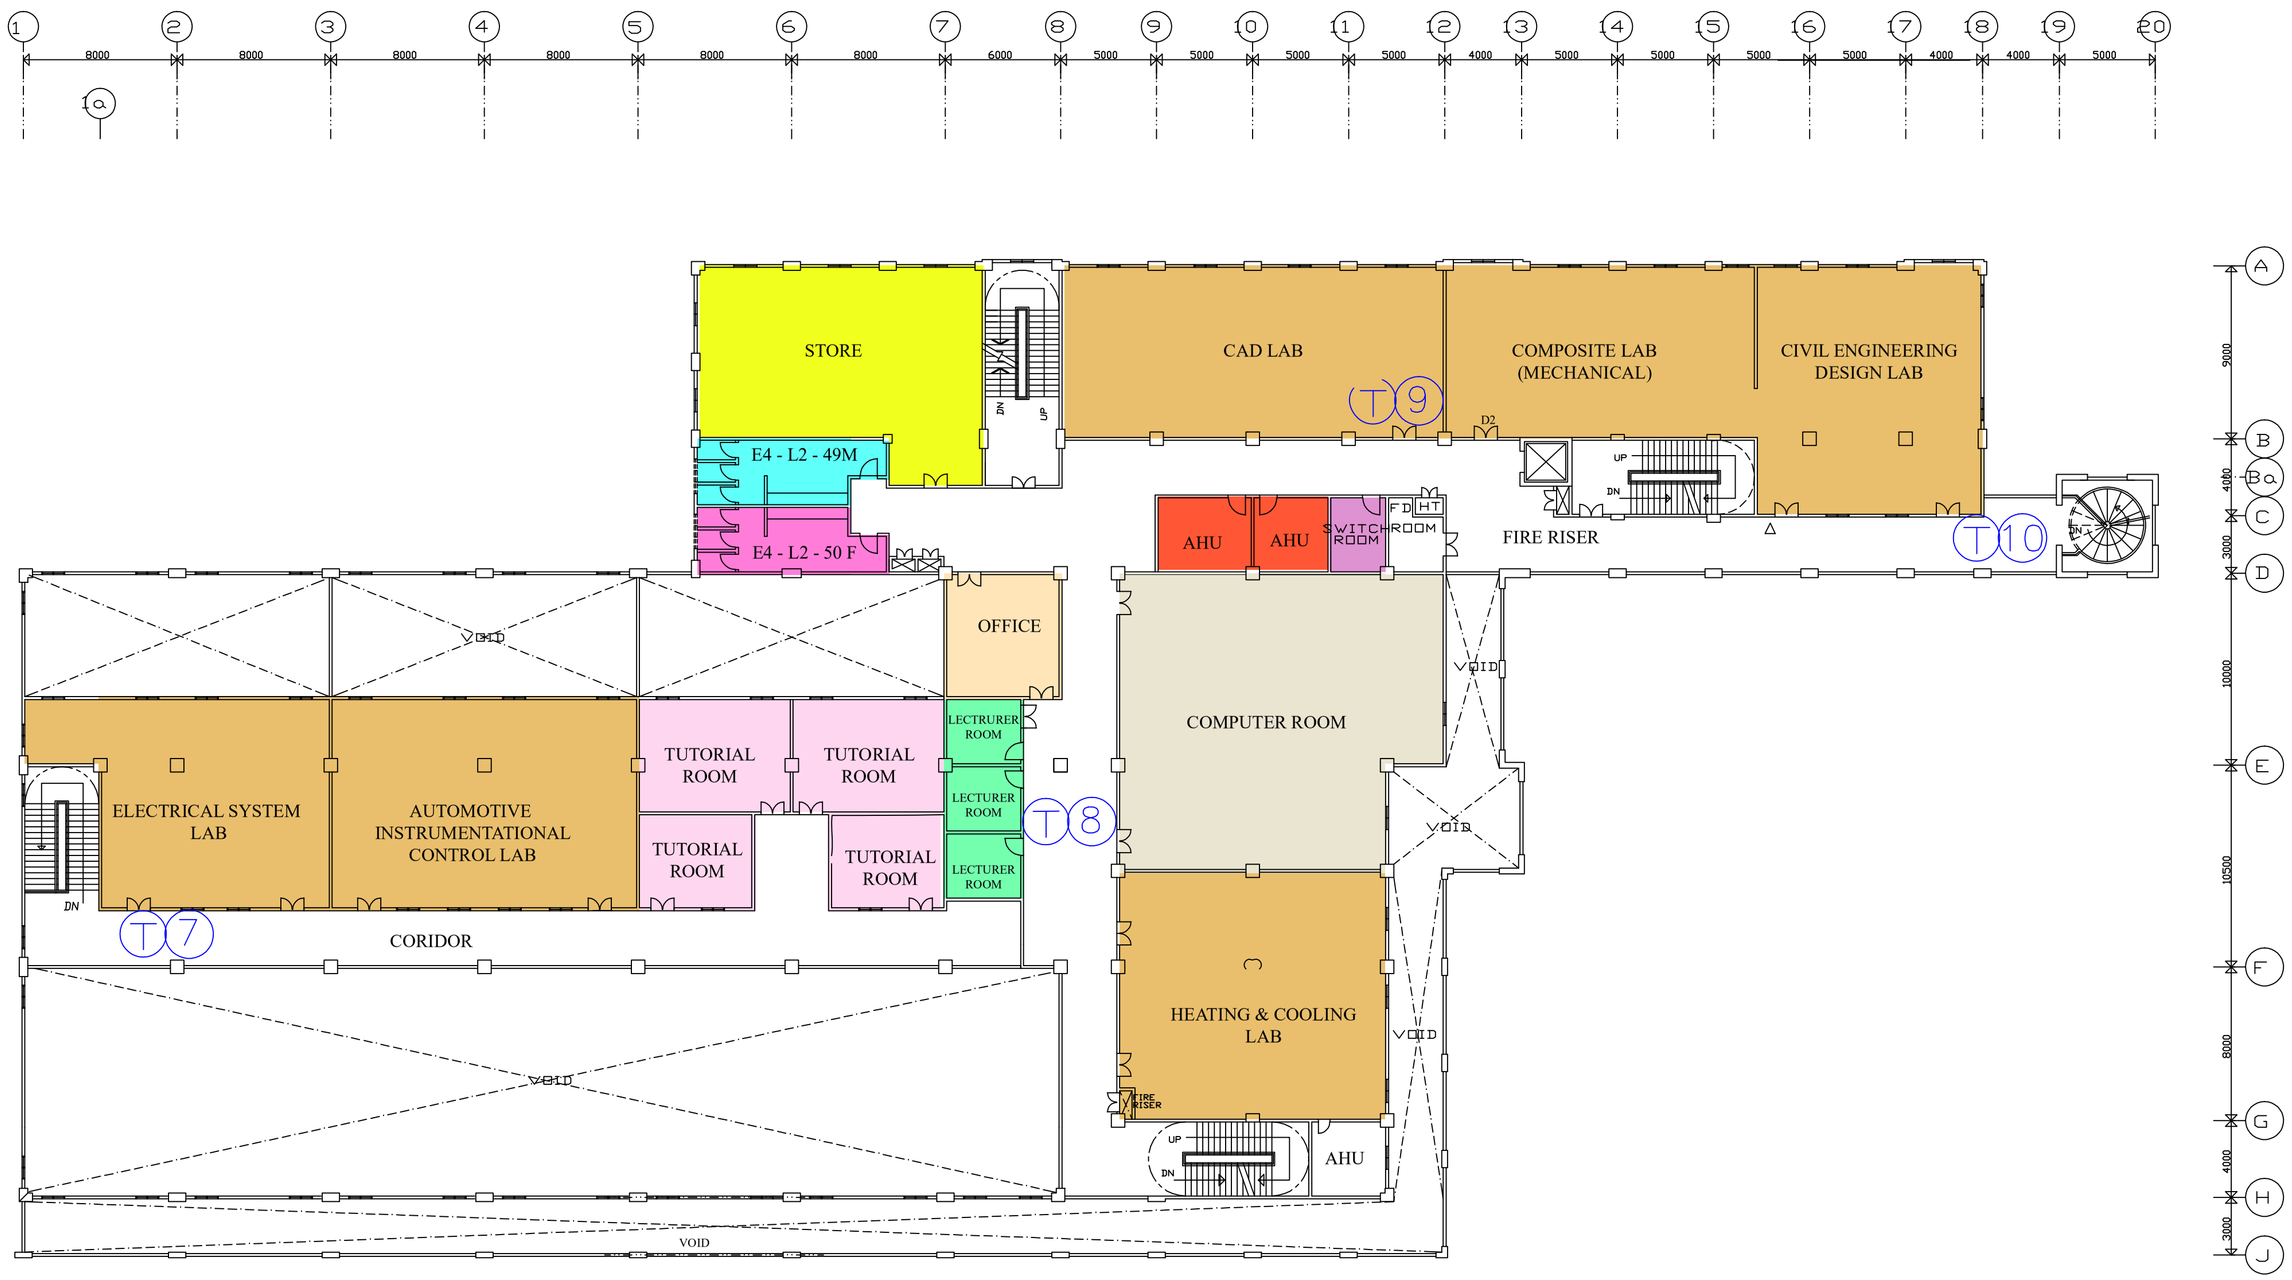

FIRST FLOOR PLAN
(BLOCK E4)

SCALE 1 : 150

AS BUILT DRAWING

INTERNATIONAL ISLAMIC UNIVERSITY

INTERNATIONAL ISLAMIC UNIVERSITY MALAYSIA
PROPERTY MANAGEMENT DIVISION
JALAN GOMBAK
53100 KUALA LUMPUR

TEL : 603-20564401
FAX : 603-20564857

PROJEK:
CADANGAN MEMBEKAL, MEMASANG, MENGUJI/TERIMA SISTEM AUTOMASI BANGUNAN (B.A.S), KAMERA LITAR TERTUTUP (C.C.T.V), SISTEM KAWALAN LALUAN DAN JARINGAN KAWASAN TEMPATAN (L.A.N) UNTUK UNIVERSITI ISLAM ANTARABANGSA MALAYSIA, GOMBAK, SELANGOR DARUL EHSAN.

NOTES

- IDVRS – INTELLEGENT DIGITAL VIDEO RECORDING SYSTEM CONTROLLER
- IDVRS – INTELLEGENT DIGITAL VIDEO RECORDING SYSTEM CONTROLLER
- HIGH IMPACT PVC FOR CARD ACCESS
- HIGH IMPACT PVC FOR CCTV
- HIGH IMPACT PVC FOR POWER SUPPLY
- ACCESS ALARM CONTROL UNITS (AM-168)
- MAGNETIC DOOR CONTACTS
- L① ACCESS CONTROL DOOR "IN" READER WITH PUSH BUTTON EXIT (AD-15L)
- L② ACCESS CONTROL DOOR "IN" & "OUT" READER (AD-15L)
- ① GUARD TOUR POINT
- FAST DOME CAMERA C/W P/T/Z RG 59 + POWER + SCREENED CABLE 2 PAIR TWISTED
- FIXED DOME CAMERA RG 59 + POWER
- DISTRIBUTION BOARD (DB)

NO.	DESCRIPTION	DATE	REV.

JKR

PENGARAH
PEJABAT TAPAK
(UNIT PROJEK UIAM)
KM 15, JALAN SUNGAI PUSU
53100 GOMBAK
SELANGOR DARUL EHSAN
TEL : 03 - 61873461/6

JABATAN KERJA RAYA MALAYSIA

M & E ENGINEERS
JUARACONSULT SDN BHD
CONSULTING ENGINEERS
(MECHANICAL & ELECTRICAL)
NO. 324-1 JALAN MIDAH BESAR
TAMAN MIDAH,CHERAS,
56000 KUALA LUMPUR
TEL : 603-91738311
FAX : 603-91738377

KONTRAKTOR SISTEM AUTOMASI BANGUNAN
KEJURUTERAAN ASTRA SDN.BHD.
35, JALAN U1/35,SECTIOJN U1
HICOM GLENMARIE INDUSTRIAL PARK
40150 SHAH ALAM.
TEL : 03-55698868
FAX : 03-55698989

TAJUK LUKISAN

CCTV, ACCESS CONTROL SYSTEM

EXTENSION OF THE KULLIYYAH

OF ENGINEERING (BLOCK E4)

FIRST FLOOR PLAN

SCALE :	1:200
DATE :	JAN 2006
DRAWN BY :	HAIRUL ADAM
CHECKED BY :	KHAIRUL
APPROVED BY :	
REFERENCE :	

NO. LUKISAN

K616/UIA-IBSS/KAACS-10/E4-F1