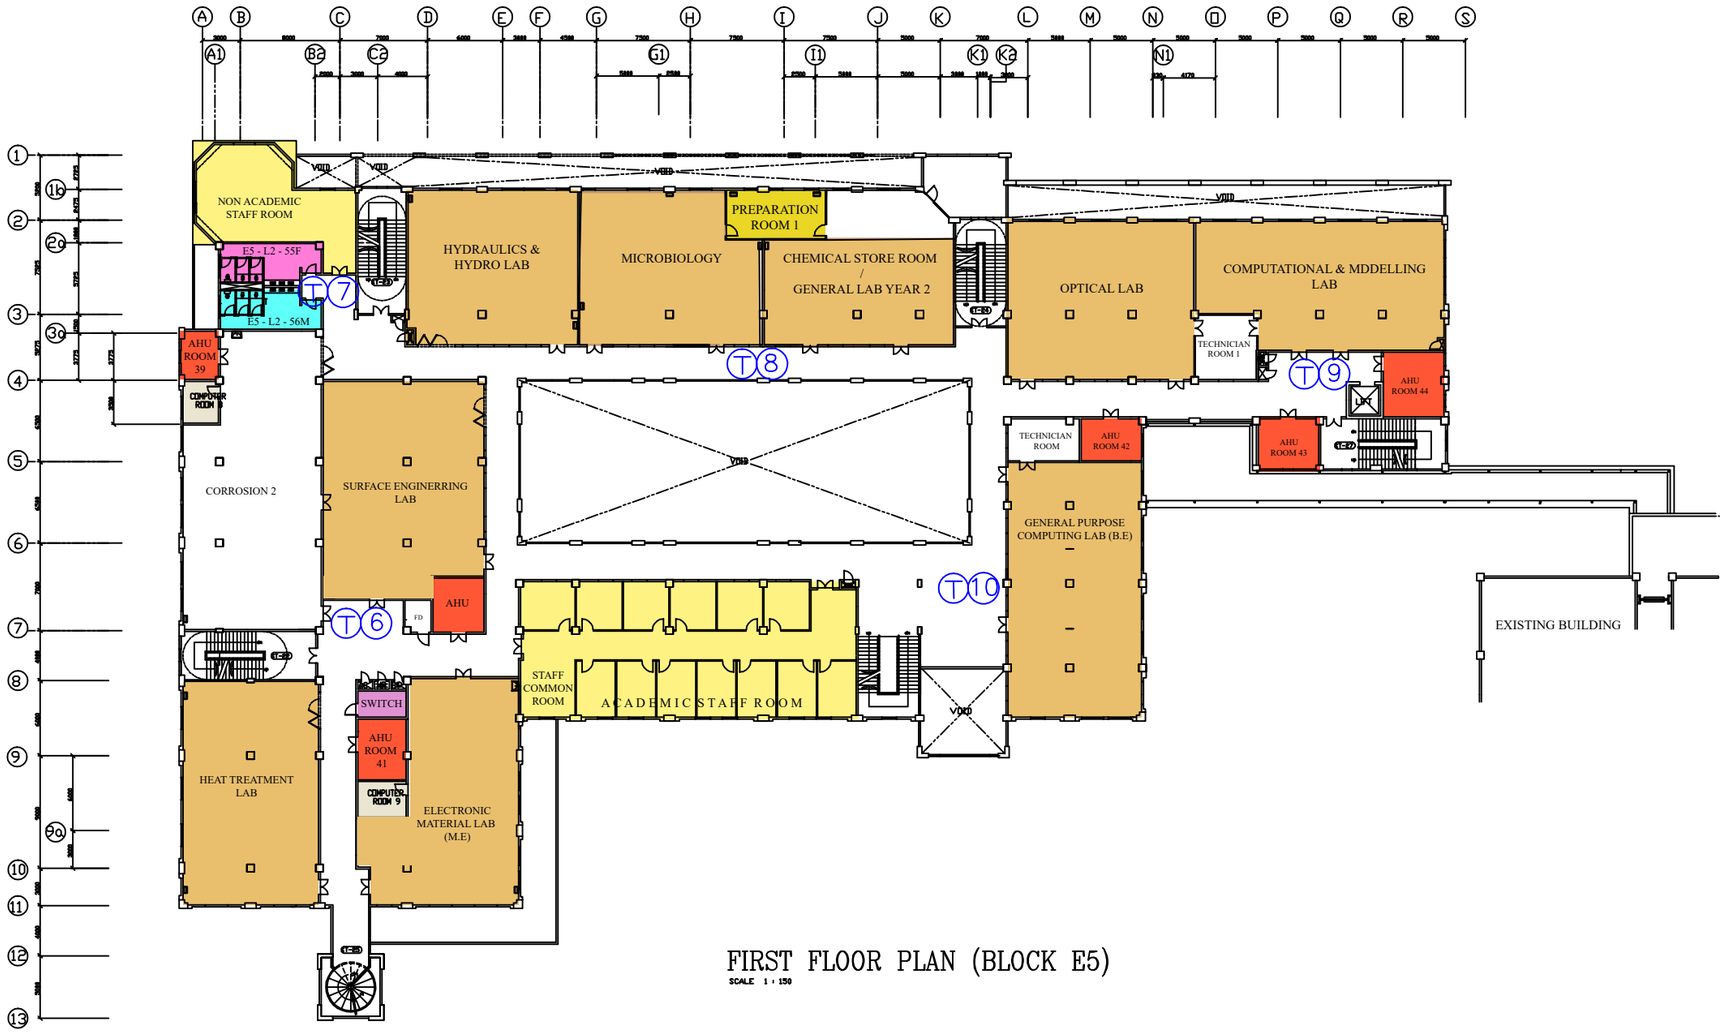

FIRST FLOOR PLAN (BLOCK E5)

SCALE 1 : 150

AS BUILT DRAWING

INTERNATIONAL ISLAMIC UNIVERSITY

INTERNATIONAL ISLAMIC UNIVERSITY MALAYSIA
PROPERTY MANAGEMENT DIVISION
JALAN GOMBAK
53100 KUALA LUMPUR

TEL : 603-20565401
FAX : 603-20564857

PROJEK:
CADANGAN MEMBEKAL, MEMASANG, MENGUJITERIMA SISTEM AUTOMASI BANGUNAN (B.A.S), KAMERA LITAR TERTUTUP (C.C.T.V), SISTEM KAWALAN LALUAN DAN JARINGAN KAWASAN TEMPATAN (L.A.N) UNTUK UNIVERSITI ISLAM ANTARABANGSA MALAYSIA, GOMBAK, SELANGOR DARUL EHSAN.

NOTES

BMS – INTELLIGENT DIGITAL VIDEO RECORDING SYSTEM CONTROLLER		
BMS – INTELLIGENT DIGITAL VIDEO RECORDING SYSTEM CONTROLLER		
HIGH IMPACT PVC FOR CATV ACCESS		
HIGH IMPACT PVC FOR CATV		
HIGH IMPACT PVC FOR POWER SUPPLY		
ACCESS ALARM CONTROL UNITS (HB-140)		
ENGINEERS DOOR CONTACTS		
L①	ACCESS CONTROL DOOR "IN" READER WITH PUSH BUTTON EXIT (HB-10L)	
L②	ACCESS CONTROL DOOR "IN" & "OUT" READER (HB-11L)	
①	GUARD TOUR POINT	
	FIXED DOME CAMERA C/W P/T/Z 50 SD + POWER + SCREENED CABLE 2 PAIR TWISTED	
	FIXED DOME CAMERA 50 SD + POWER	
	DISTRIBUTION BOARD (DB)	

NO.	DESCRIPTION	DATE	REV.

JKR

PENGURUSAN PEJABAT TAPAK
(UNIT PROJEK UIAM)
NO 15, JALAN SUNGAI PUSU
53100 GOMBAK
SELANGOR DARUL EHSAN
TEL : 03 - 61825424/6

JABATAN KERJA RAYA MALAYSIA

M & E ENGINEERS
JUARACONSULT SDN BHD
CONSULTING ENGINEERS
(MECHANICAL & ELECTRICAL)
NO. 324-1 JALAN MIDAH BESAR
TAMAN MIDAH,CHERAS,
56000 KUALA LUMPUR
TEL : 603-91738311
FAX : 603-91738377

KONTRAKTOR SISTEM AUTOMASI BANGUNAN
KEJURUTERAAN ASTRA SDN.BHD.
36, JALAN U1/36,SECTION U1
HICOM GLENMARIE INDUSTRIAL PARK
40150 SHAH ALAM.
TEL : 03-55600555
FAX : 03-55600550

TAJUK LUKISAN
CCTV, ACCESS CONTROL SYSTEM
EXTENSION OF THE KULLIYYAH
OF ENGINEERING (BLOCK E5)
FIRST FLOOR PLAN

SCALE :	1:150
DATE :	JAN 2010
DRAWN BY :	MOHD.JEFRI
CHECKED BY :	RAHMAN.
APPROVED BY :	
REFERENCE :	

NO. LUKISAN
K616/UIA-IBSS/KAACS-10/E5-F1